




- Reference
- BNK - Bank
 - BM - Bench Mark
 - BBTM - Bank Bottom
 - Con. - Concrete
 - CONP - Concrete Paving
 - CP - Concrete Post
 - CPB - Concrete Paving Block
 - DB △ - Direction Board
 - EDn - Earth Drain
 - EP ↑ - Electric Post
 - EPH ↑ - Electric Post High Tension
 - G - Gate
 - IF - Iron Fence
 - LF - Live Fence
 - MDn - Masonry Drain
 - MH - Manhole
 - MHW - Manhole (Water)
 - MHT - Manhole (Telecom)
 - MHE - Manhole (Electric)
 - MS - Marshy area
 - NB △ - Name Board
 - PF - Paddy Field
 - PO □ - Post Office Box
 - RDA □ - Road of the Way
 - RW - Retaining Wall
 - RK - Rock
 - S - Slope
 - SB △ - Sign Board
 - SH - Shoulder Edge
 - SE - Shoulder Edge
 - TE - Tar Edge
 - Tr - Tea Cultivation
 - Tr ↑ - Tree
 - TP ↑ - Telephone Post
 - U - Undefined Boundary
 - W - Boundary Wall
 - WL - Water Line
 - WF - Wire Fence
 - WLF - Wire Live Fence
 - WFN - Wire Net Fence
 - WFC - Concrete Wire Fence
 - WM - Water Meeter
 - WB - Water Board Post
 - Type B - Excavated Soil

- Pipe line
- Orifice Air valve(OAV)
- Sluice valve
- Wash Out Valve

Node 03 630 ENDCAP

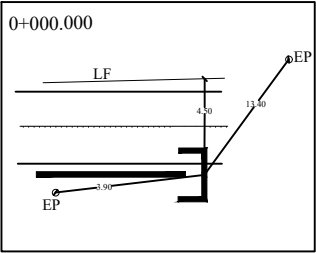

Node 02 630 EQ TEE

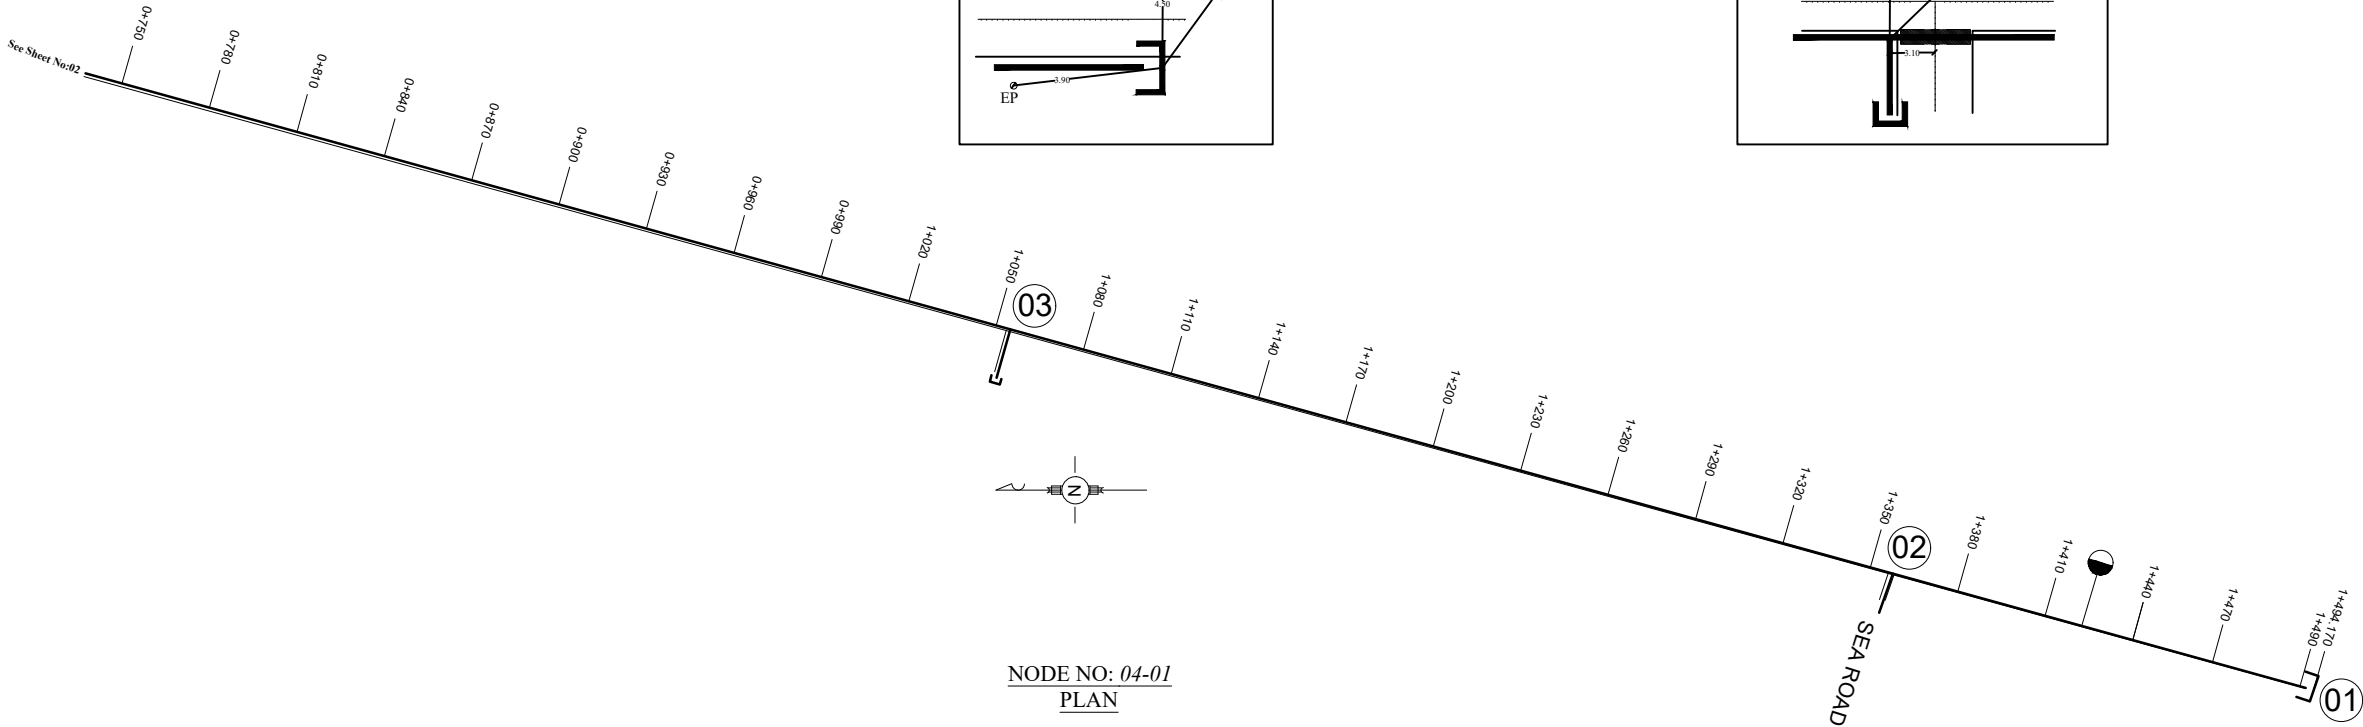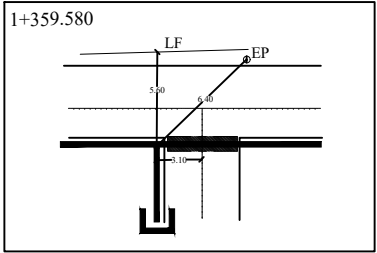

NODE NO: 04-01
PLAN

<div>6.00 4.00 2.00 0.00 -2.00 -4.00</div> <div>CONTOUR SHEET NO.02</div> <div>DATUM -5.00 M.S.L</div>																					
--	--	--	--	--	--	--	--	--	--	--	--	--	--	--	--	--	--	--	--	--	--


CLIENT:

NATIONAL WATER SUPPLY AND DRAINAGE BOARD
JAFFNA KILINOCHCHI WATER SUPPLY AND SANITATION PROJECT

CONSTRUCTION OF WATER TOWERS AT POMMAIVELI, KARAVEDDY, NAINATIVU, ANALAITIVU AND ELUVAITIVU

CONTRACT NO: PEIC/JKWSSP/WATER TOWERS/2017/01

MAIN CONTRACTOR:

 **SQUIRE MECH ENGINEERING(PVT) Ltd**

REV NO.	DESCRIPTION	BY	DATE	DRAWN BY (SQUIRE MECH):	CHECKED BY (SQUIRE MECH):
				TL (JKWSSP):	
				PE (JKWSSP):	
				CE (JKWSSP):	
				DPD (JKWSSP):	
				PD (JKWSSP)	

AS BUILT DRAWING

TITLE: CONSTRUCTION OF WATER TOWERS AT POMMAIVELI, KARAVEDDY, NAINATIVU, ANALAITIVU AND ELUVAITIVU

DATE: 22.05.2023	SCALE: H 1:2500 V 1:500	SHEET NO: 03	DWG NO: AS-BUILT/PIPE/TOWERS/
------------------	-------------------------	--------------	-------------------------------